


**Project**  
**DANET ABU DHABI**  
 PLOT No. 43  
 ABU DHABI  
 UNITED ARAB EMIRATES

**Client**

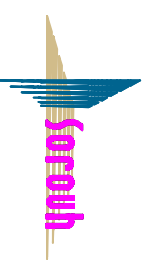

Tel: (+971) 4 361 1111 - Fax: (+971) 4 361 1111 - 212, Abu Dhabi - Abu Dhabi  
 (United Arab Emirates)

**Client Project No.:**

**Project manager:**

**NES** شركة النيس  
 GENERAL CONTRACTOR  
 "MISRAH ENGINEERING SERVICES" PO BOX 2450184 FZ-2450184 (DUBAI)

**Consultants**



**ZNA**  
 ZENBERKOGUJ NAYMAN ASSOCIATES, INC.  
 ARCHITECTS, URBAN DESIGNERS



**C R J I A**  
 CIVIL & ARCHITECT ASSOCIATES

**Main contractor:**



**NPC-BCEG JV**

www.npc-bceg.com  
 www.npc-bceg.com




**HR FIRE RATED WALL**  
**HR FIRE RATED WALL**

**AS BUILT**  
**FLAT NO.9**

Scale	N.T.S	Date	28/10/09
Drawn	M.Faisal	Checked	Amjed
Drawing Title:			

**Drawing Number:**

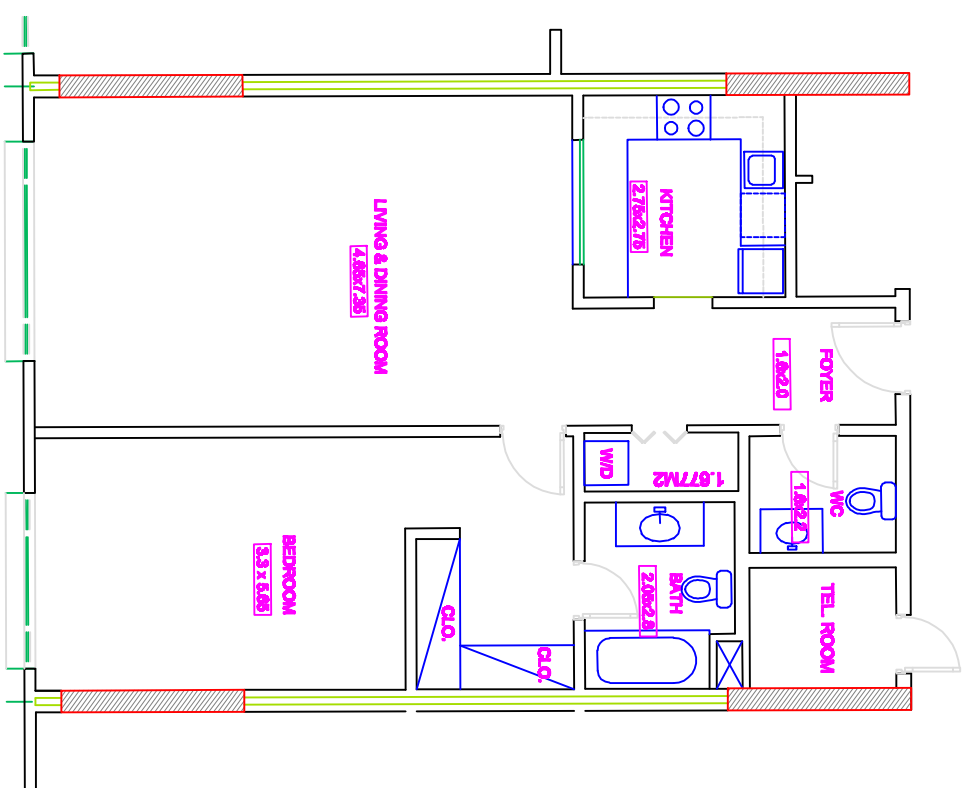

**FLAT NO.9**  
**1BEDROOM**

