


**Project**  
**DANET ABU DHABI**  
 PLOT No. 43  
 ABU DHABI  
 UNITED ARAB EMIRATES

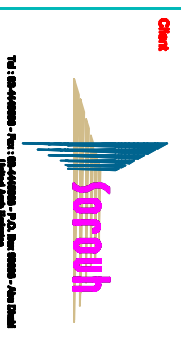

**Client Project No.:**  
**Project manager:**  
**NES** (مركز خدمات العملاء)  
 MESTER ENGINEERING LLC  
 P.O. BOX 2450181, FIVE STAR PARK, ABU DHABI


**Consultants:**  
**ZNA** ZENBERKOGULI NAYMAN ASSOCIATES, INC.  
 ARCHITECTS, INTERIOR DESIGNERS  
**EHAF**  
**C R J I A** CAROL & JOHNNY ASSOCIATES INC.

**Main contractor:**  
**NPC** NPC-BCEG JV  
**Legend:**  
 Concrete wall  
 Hollow block wall  
 1HR FIRE RATED WALL  
 2HR FIRE RATED WALL

**AS BUILT**  
**FLAT NO.10**

Scale	N.T.S	Date	28/10/09
Drawn	M.Fahad	Checked	Amjed
Drawing Title:			

**Drawing Number:**

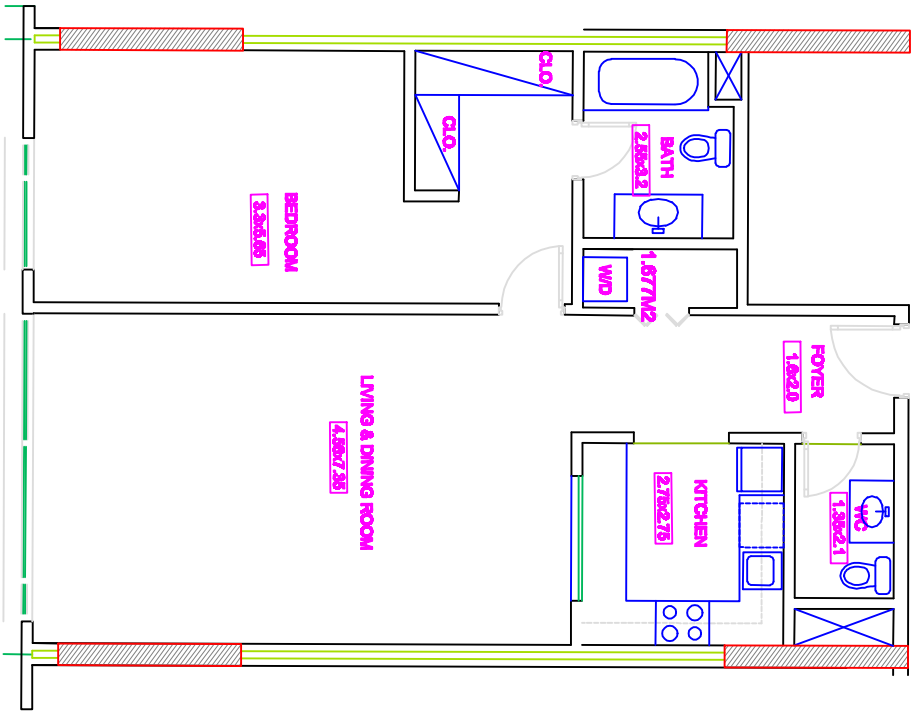

**FLAT NO.10**  
**1BEDROOM**

