


Project
DANET ABU DHABI
 PLOT No. 43
 ABU DHABI
 UNITED ARAB EMIRATES

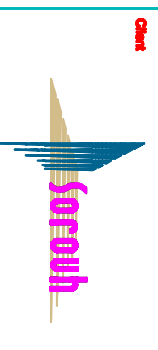

Client Project No.:
Project manager:
NES
 شركة نيس
 مهندسين معماريين رقم 02-550184 رقم 02-550184 رقم 02-550184



Consultants
ZNA
 ZENBERKOGULI NAYMAN ASSOCIATES, INC.
 ARCHITECTS, INTERIORS DESIGNERS
EHAF
C R J I A
 CIVIL & ARCHITECT ASSOCIATES

Main contractor:
NPC
 NPC-BCEG JV

Legend:
 Concrete wall
 Hollow block wall
 IHR FIRE RATED WALL
 IHR FIRE RATED WALL

AS BUILT
FLAT NO.7

Scale	N.T.S	Date	28/10/09
Drawn	M.Faisal	Checked	Amjed
Drawing Title:			
Drawing Number:			

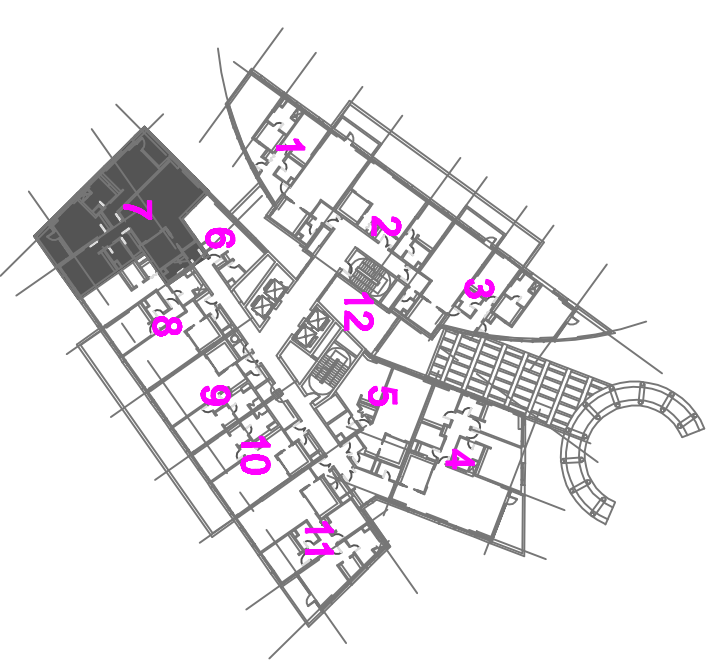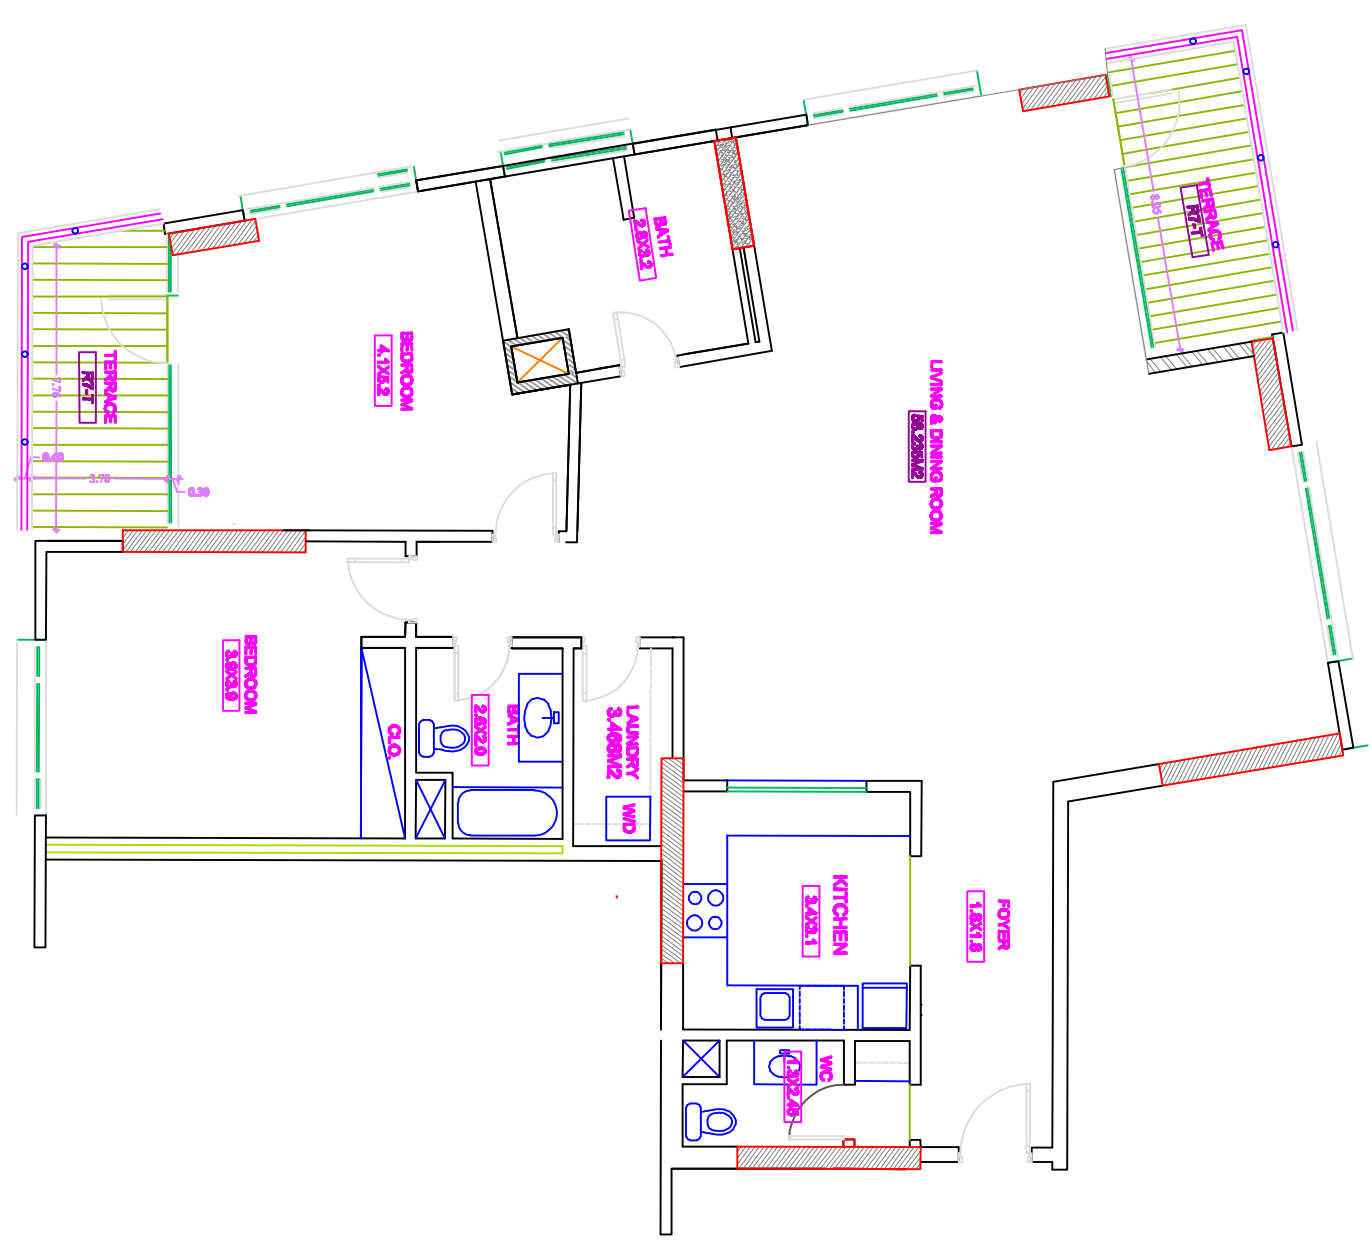

FLAT NO.7

2 BEDROOMS