


**Project**  
**DANET ABU DHABI**  
 PLOT No. 43  
 ABU DHABI  
 UNITED ARAB EMIRATES

**Client**

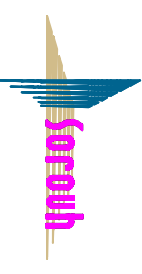

Tel: 02-4501081 - Fax: 02-4501080 - 23, Bay Street - Abu Dhabi  
 (United Arab Emirates)

**Client Project No.:**

**Project manager:**

**NES** شركة نيس  
 "مركز خدمات العملاء"  
 "مركز خدمات العملاء"  
 "مركز خدمات العملاء"  
 "مركز خدمات العملاء"

**Consultants**

**ZNA**  
 ZENBERKOLU NAYMAN ASSOCIATES, INC.  
 ARCHITECTS, INTERIORS DESIGNERS



**C R J I A**  
 CIVIL & ARCHITECT ASSOCIATES INC.

**Main contractor:**

**NPC**  
 NPC-BCEG JV


www.npc-bceg.com



**AS BUILT**  
**FLAT NO.8**

Scale	N.T.S	Date	28/10/09
Drawn	M.Faisal	Checked	Amjed
Design Title:			

**Drawing Number:**

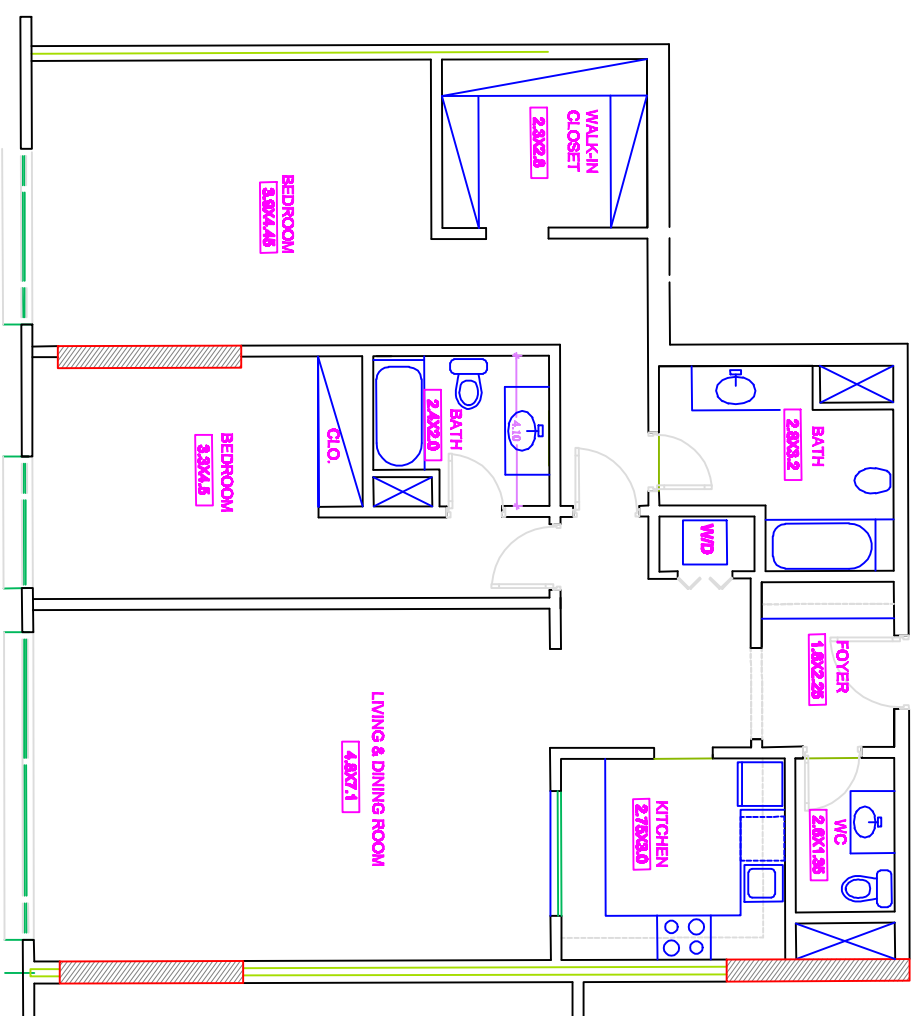

**FLAT NO.8**  
**2BEDROOMS**

