



Project
DANET ABU DHABI
 PLOT No. 43
 ABU DHABI
 UNITED ARAB EMIRATES

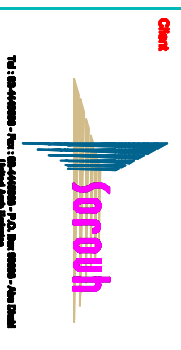

Client Project No.:
Project manager:
NES شركة النور
 MANAGEMENT SERVICES P.O. BOX 2450181 FIVE STAR ROAD SAUDI ARABIA

Consultants
ZNA ZENBERKOGULI NAYMAN ASSOCIATES, INC.
 ARCHITECTS, INTERIOR DESIGNERS
EHAF
 C R J I A
 CIVIL & ARCHITECT ASSOCIATES



Main contractor:
NPC NPC-BCEG JV

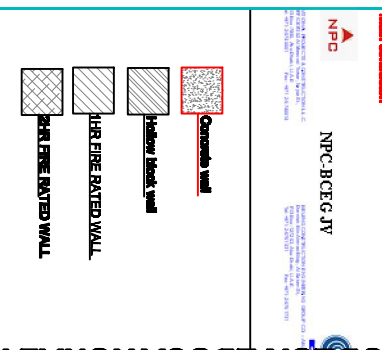

AS BUILT
FLAT NO.6

Scale	N:1:5	Date	28/10/09
Drawn	M.Fahad	Checked	Amjed
Drawing Title:			

Drawing Number:

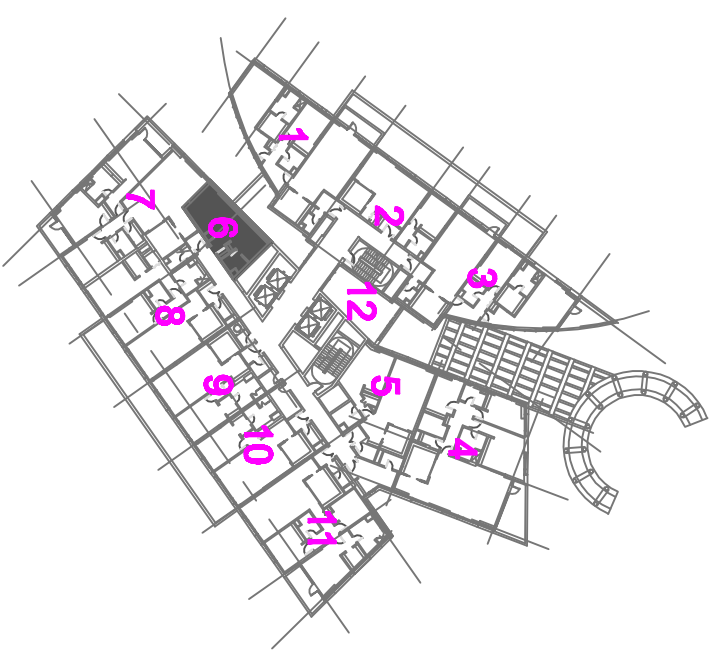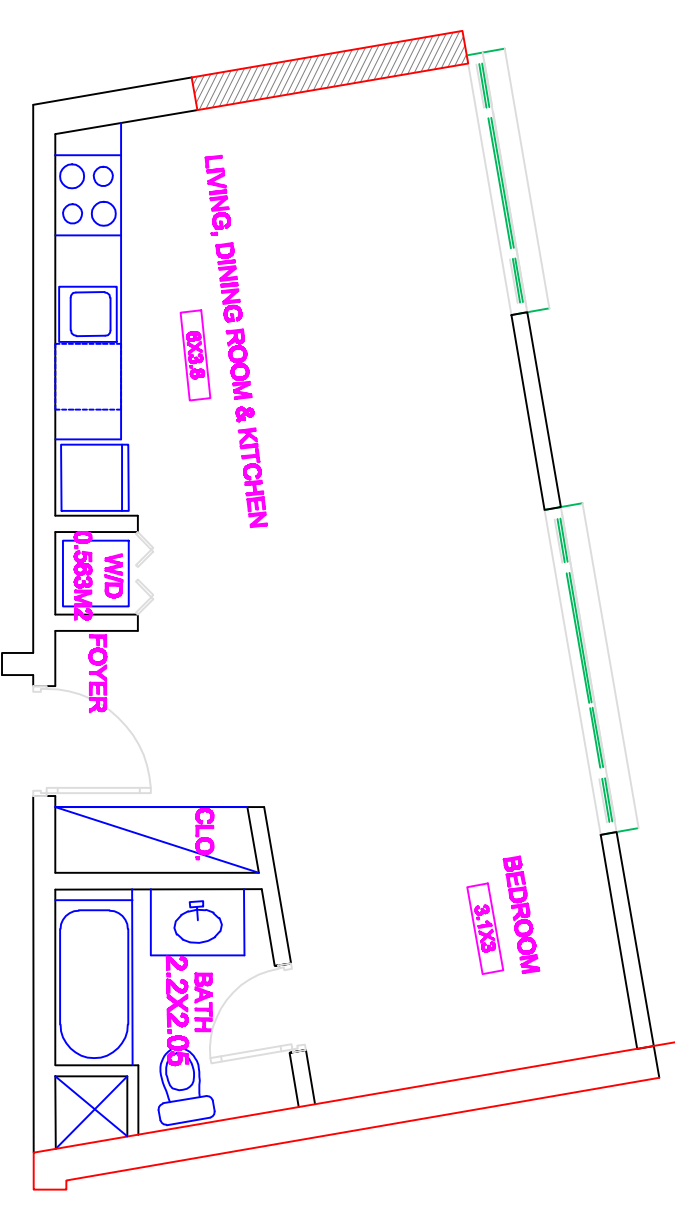

FLAT NO.6
STUDIO